

LABOR AND MATERIALS


1	Copper	} Connection $3/4"$	\$
Lead			
1	Curb	} Cock Valve T.S. & V. $3/4"$ in. <i>MAY 2-27</i>	\$
1	Service box	} Short $3\frac{1}{2} \times 4\frac{1}{2}$ Long $4\frac{1}{2} \times 5\frac{1}{2}$ Box or Rdway	\$
Old returned			
9	Ft. $3/4"$ in.	} Copper C.I. Pipe at	\$
	Nipples	in. at	\$
	Bushings	to in. at	\$
	Red'g	} Coupl'gs to in. at	\$
	Inc'g		
	Union	in. at	\$
	Meter	in. at	\$
	Lead Joints	at	\$
	Compound Joints	at	\$
	Maintenance Foreman		\$
	Hrs. Water Maint. Man-1	at	\$
	Hrs. Water Maint. Man-2	at	\$
	Hrs. Garage Foreman	at	\$
	Hrs. Labor	at	\$
	Hrs. Compressor	at	\$
	Compensation Ins. at \$	per C.	\$
	Trucking		\$
	Pav't Patch		\$
	<i>Tap made by Beeco ho to</i>		\$
	O'head <i>April-1974</i>		\$
			\$

IOH

St. Ave. No. 6

Name of Owner

Labor and Mat'l. Report *April - 1974*

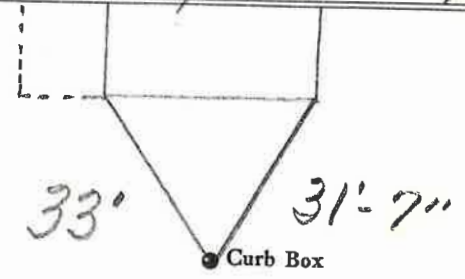

6" Main

Elev. of Main at tap 51

Gate at • Gate at

TAX ID # 309.12-7-2

• Curb Box

changed over from old 2" MAIN to New 6" MAIN April-1974 ✓