


Labor and Materials

1	Copper	Connection	3/4	\$	96
1	Curb	Cock Valve T.S.&V.	3/4 in	\$	1.33
1	Service Box	Short 3 1/2 x 4 1/2		\$	1.35
	Old returned	Long 4 1/2 x 5 1/2			
		Buff. or Rdway			
9	Ft. 3/4 in.	Copper Galv. Iron Cast Iron	Pipe at	15	1.35
	Nipples	in. at		\$	
	Bushings	to in. at		\$	
	Red'g Inc'g	Couplings	to in. at	\$	
	Union	in. at		\$	
	Meter	in. at		\$	
	Lbs. Br. Stone	at		\$	
	Lbs. Sand	at		\$	
	Bags Cement	at		\$	
	Paving Brick	Mack Red Asphalt	at	\$	
	Lead Joints	at		\$	
	Leadite Joints	at		\$	
2 1/2	Hrs. Foreman	at	6 1/2	\$	1.25
5	Hrs. Common Labor	at	50	\$	2.50
1	Hrs. Common Labor	at	45	\$	45
	Hrs. Mason	at		\$	
	Hrs. Masons Helper	at		\$	
	Hrs. Compressor	at		\$	
	Compensation Ins			\$	13
	Trucking			\$	1
	Builders Use of Water	(Sewer)		\$	2.50
				Total \$	12.82

9036
Labor and Material Report Sept 28 1916

2 Jackson Ave - 3rd Tap
Sullivan

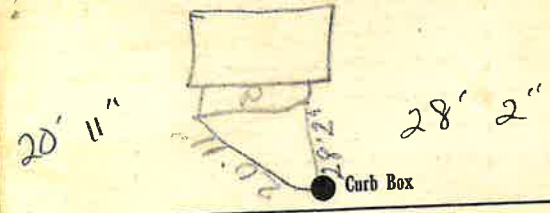

6" Main Elev. of Main at tap 4 1/2

Gate at ● Gate at ●

● Curb Box

New House

AM