


Labor and Materials

Copper } Connection.....	3	\$2.60
Lead }	3	
Curb } Cock }	3	\$2.27
Valve } T.S. & V. }	3	
Service Box } Short Box 4" }		\$1.59
Old returned } Long 4" x 5" }		
Buff. or Rdway }		
22 Ft. } in. } Copper } Pipe at.....	3	\$5.04
Galv. Iron }	4	
Cast Iron }		
Nipples..... in. at.....		\$
Bushings..... to..... in. at.....		\$
Red'g } Couplings..... to..... in. at.....		\$
Inc'g }		\$
Union..... in. at.....		\$
Meter..... in. at.....		\$
Lbs. Br. Stone at.....		\$
Lbs. Sand at.....		\$
Bags Cement at.....		\$
Paving Brick } Mack } at.....		\$
Red }		\$
Asphalt }		\$
Lead Joints at.....		\$
Leadite Joints at.....		\$
3 Hrs. Foreman at.....		\$1.88
1 Hrs. Common Labor at <i>Tapper</i>		\$.50
15 Hrs. Common Labor at.....		\$ 6.75
Hrs. Mason at.....		\$
Hrs. Mason's Helper at.....		\$
Hrs. Compressor at.....		\$
Compensation Ins.....		\$.28
Trucking.....		\$ 1.00
Builders' Use of Water <i>in pit at 1.00</i>		\$
Total \$		21.91

Labor and Material Report

New 7 1931

18 Jackson St.

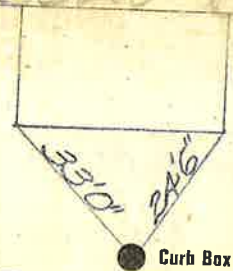

Curb Box

6" Main

Elev of Main at top 4'

Gate at ●

● Gate at

● Curb Box

No measurements.

New House.