

LABOR AND MATERIALS

1	Copper	{	Connection	3/4"	\$	3.04
	Lead					
1	Curb	{	Cock Valve	3/4" in.	\$	3.54
			T. S. & V.			
1	Service box	{	Short	3 1/2 x 4 1/2		
	Old returned		Long	4 1/2 x 5 1/2	\$	4.70
			Buff or Rdway			
10	Ft.	3/4 in.	Copper	Pipe at	35	\$ 3.50
			G. I.			
			C. I.			
	Nipples	in. at			\$	
	Bushings	to in. at			\$	
	Red'g	{	Coupl'gs	to in. at	\$	
	Inc'g					
	Union	in. at			\$	
	Meter	in. at			\$	
	Lead Joints at				\$	
	Compound Joints at				\$	
1	Hrs. Water Maint. Man	1 at			\$	12.30
4	Hrs. Water Maint. Man	2 at	1.13		\$	45.20
	Hrs. Labor	at			\$	
	Hrs. Labor	at			\$	
1	Hrs. Compressor at				\$	1.50
	Compensation Ins. at \$	per C.			\$	15
	Trucking				\$	1.00
	Pav't Patch				\$	18.00
					\$	
					\$	
	O'head				\$	
					\$	41.13

Top made by Warsinski
Sept 27-51

LSM-1171

Jackson


Ave. No. 23

Name of Owner

Crowe

Labor and Mat'l. Report

Sept 27 1951

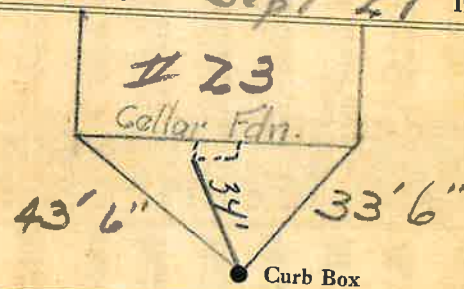

6" Main

Elev. of Main at tap 5'

Gate at ●

● Gate at

● Curb Box