

LABOR AND MATERIALS

1	Copper Lead	Connection	5/4"	\$
1	Curb	Cock Valve T. S. & V.	3/4 in. Orisical	\$
1	Service box	Short 3 1/2 x 4 1/2		
	Old returned	Long 4 1/2 x 5 1/2		
		Buff or Rdway		\$
17	Ft.	3/4 in. Copper G.I. G.I.	Pipe at	\$
	Nipples	in. at		\$
	Bushings	to in. at		\$
	Red'g			
	Inc'g	Coupl'gs to in. at		\$
	Union	in. at		\$
	Meter	in. at		\$
	Lead Joints	at		\$
	Compound Joints	at		\$
	Maintenance Foreman			\$
	Hrs. Water Maint. Man-1	at		\$
	Hrs. Water Maint. Man-2	at		\$
	Hrs. Garage Foreman	at		\$
	Hrs. Labor	at		\$
	Hrs. Compressor	at		\$
	Compensation Ins. at \$	per C		\$
	Trucking			\$
	Pav't Patch			\$
	Tap by Kell & Miller			\$
				\$
		7-30-64.		\$
	O'head			\$
				\$

Jackson

St. _____
Pl. _____
Ave. No. 25


Name of Owner

Joseph Fiato

Labor and Mat'l. Report

July 30

19 64.

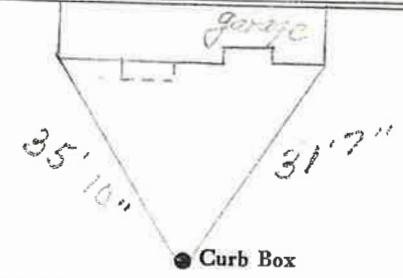

● Curb Box

12" C.I. Main

Elev. of Main at tap 5'

Gate at ●

● Gate at

TAX ID # 303.9-11-5

● Curb Box