


Labor and Materials

.. Copper } Connection.....	2	\$ 1.48
.. Lead }			
.. Curb { Cock	}	in	\$ 1.79
.. Valve			
.. T.S.&V.			
.. Service Box { Short 3 1/2 x 4 1/2	}		\$ 1.30
.. Old returned Long 4 1/2 x 5 1/2			
.. Buff. or Redway			
.. Ft. in. { Copper	} Pipe at	3/4	\$ 1.98
.. Galv. Iron			
.. Cast Iron			
.. Nipples	in. at		\$
.. Bushings	to	in. at	\$
.. Red'g	} Couplings.....	to	in. at
.. Inc'g			
.. Union.....	in. at		\$
.. Meter.....	in. at		\$
.. Lbs. Br. Stone at			\$
.. Lbs. Sand at			\$
.. Bags Cement at			\$
.. Paving Brick { Mack	} at		\$
.. Red			
.. Asphalt			
.. Lead Joints at			\$
.. Leadite Joints at			\$
.. 3 Hrs. Foreman at			\$ 1.98
.. 6 Hrs. Common Labor at			\$ 2.70
.. Hrs. Common Labor at			\$
.. Hrs. Mason at			\$
.. Hrs. Masons Helper at			\$
.. Hrs. Compressor at			\$
.. Compensation Ins			\$ 14
.. Trucking			\$ 1-
.. Builders Use of Water	Patch		\$ 2.50
Total \$			14.77

3290

Labor and Material Report Aug 9 1912

3 Jackson Ave

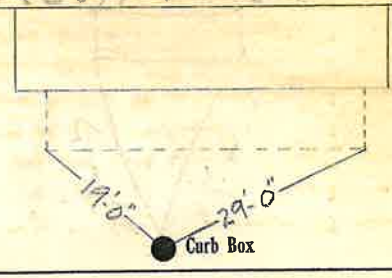

6 Main

Elev. of Main at tap 4 1/2

Gate at ●

● Gate at

● Curb Box

New Tap with
Sewer

OK 9/10