


Labor and Materials

1. Copper	} Connection.. $\frac{3}{4}$	.....	\$. 1.33	
Lead				
1. Curb	} Cock Valve P.S.&V. } .. $\frac{3}{4}$ in	.....	\$. 1.58	
1. Service Box	} Short $3\frac{1}{2} \times 4\frac{1}{2}$ Long $4\frac{1}{2} \times 5\frac{1}{2}$ Buff or Paper	.....	\$. 1.36	
Old returned				
9. Ft. $\frac{3}{4}$ in.	} Copper Galv. Iron Cast Iron	Pipe at .....	\$. 8.4	
Nipples .....				in. at .....
.....	Bushings .....	to .....	in. at .....	\$. .....
1. Red's Inc's	} Copper Couplings.. $\frac{3}{4}$ to $\frac{3}{4}$	.....	\$. 1.0	
.....				
.....	Union.....	in. at .....	\$. .....	
.....	Meter.....	in. at .....	\$. .....	
.....	Lbs. Br. Stone at .....	.....	\$. .....	
.....	Lbs. Sand at .....	.....	\$. .....	
.....	Bags Cement at .....	.....	\$. .....	
.....	} Paving Brick { Mack Red Asphalt	at .....	\$. .....	
.....				
.....				
.....	Lead Joints at .....	.....	\$. .....	
.....	Leadite Joints at .....	.....	\$. .....	
3. Hrs.	Foreman at .....	.....	\$. 1.88	
.....	Hrs. Common Labor at .....	.....	\$. .....	
6. Hrs.	Common Labor at .....	.....	\$. 27.0	
.....	Hrs. Mason at .....	.....	\$. .....	
.....	Hrs. Masons Helper at .....	.....	\$. .....	
.....	Hrs. Compressor at .....	.....	\$. .....	
.....	Compensation Ins .....	.....	\$. 14	
.....	Trucking .....	.....	\$. .....	
.....	Builders Use of Water $\frac{1}{2}$ patch	.....	\$. 2.50	
Total \$.			13.43	

9 Jackson Ave

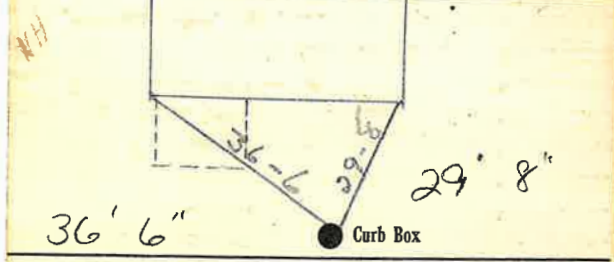

6" Main Elev. of Main at tap  $4\frac{1}{2}$

Gate at • TAX ID # 303.9-9-5 • Gate at

• Curb Box

New House  
No Measurement

*[Handwritten signature]*