


LABOR AND MATERIALS

1	Copper Lead	Connection	3/4"	\$	271
1	Curb	Cock Valve T.S. & V.	3/4 in.	\$	382
1	Service box	Short 3 1/2 x 4 1/2 Long 4 1/2 x 5 1/2 Buff or Rdway		\$	4.69
	Old returned				
20	3/4 in.	Copper G.I. C.I.	Pipe at	45	\$ 9.00
	Nipples	in. at		\$	
	Bushings	to in. at		\$	
	Red'g Inc'g	Coupl'gs	to in. at	\$	
	Union	in. at		\$	
	Meter	in. at		\$	
	Lead Joints at			\$	
	Compound Joints at			\$	
	Maintenance Foreman			\$	
	Hrs. Water Maint. Man-1	at		\$	
4	Hrs. Water Maint. Man-2	at	1.24	\$	4.96
	Hrs. Garage Foreman	at		\$	
9	Hrs. Labor	at	1.13	\$	10.17
	Hrs. Compressor at			\$	
	Compensation Ins. at	\$4.29 per C		\$	65
	Trucking			\$	1.50
	Pav't Patch			\$	14.85
	Tap by Gifford	12-7-54		\$	
	O'head			\$	
				\$	52.36

Jackson St. Ave. No. 10

Name of Owner Hay

Labor and Mat'l. Report Dec. 7 1954

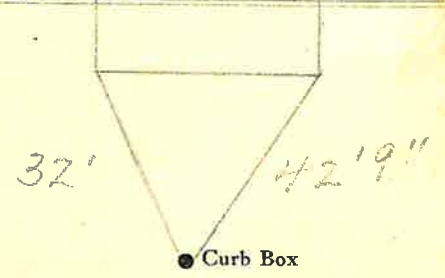

12" Main Elev. of Main at tap 5'

Gate at • • Gate at

• Curb Box