

Labor and Materials


Copper	Connection	\$ 1.50
Lead		
Curb	Cock Valve T.S. & V. in	\$ 1.70
Service Box	Short 3 1/2 x 4 1/2	\$ 1.54
	Long 4 1/2 x 5 1/2		
Old Returned	Buff. or Blw.	
10 Ft.	Copper Galv. Iron Cast Iron	Pipe at	3 1/4 \$ 1.90
Nipples in. at	\$
Bushings to in. at	\$
Red'g Inc'g	Couplings to in. at	\$
Union in. at	\$
Meter in. at	\$
Lbs. Br. Stone	at	\$
Lbs. Sand	at	\$
Bags Cement	at	\$
Paving Brick	Mack Red Asphalt	at	\$
Lead Joints	at	\$
Leadite Joints	at	\$
7 Hrs.	Foreman at	\$ 1.25
6 Hrs.	Common Labor at	\$ 3.60
Hrs.	Common Labor at	\$
Hrs.	Mason at	\$
Hrs.	Masons Helper at	\$
Hrs.	Compressor at	\$
Compensation Ins	\$ 0.17
Trucking	\$ 1.-
Builders Use of Water	Part Patch	\$ 2.50
Total			\$ 15.16

133 34

Labor and Material Report

Nov 9 1933

11 Jackson Ave

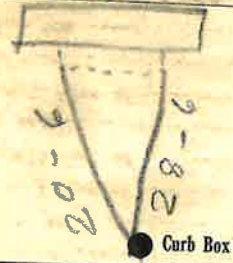

6 Main

Elev. of Main at tap 42

Gate at ●

● Gate at

● Curb Box

New House

Y Sensor

Handwritten initials or signature.