

LABOR AND MATERIALS


1	Copper Lead	Connection	3/4"	\$ 2.71
1	Curb	Cock Valve T.S. & V.	3/4 in.	\$ 3.83
1	Service box Old returned	Short 3 1/2 x 4 1/2 Long 4 1/2 x 5 1/2 Buff or Rdway	5' x 6'	\$ 4.69
26	Ft	3/4 in. { Copper G.I. C.I. } Pipe at	45	\$ 11.70
	Nipples	in. at		\$
	Bushings	to in. at		\$
	Red'g Inc'g	Coupl'gs to in. at		\$
	Union	in. at		\$
	Meter	in. at		\$
	Lead Joints	at		\$
	Compound Joints	at		\$
	Maintenance Foreman			\$
	Hrs. Water Maint. Man-1	at		\$
2	Hrs. Water Maint. Man-2	at	248	\$
	Hrs. Garage Foreman	at		\$
	Hrs. Labor	at		\$
	Hrs. Compressor	at		\$
	Compensation Ins. at	\$ 4.29 per C	11	\$ 1.50
	Trucking			\$
	Pav't Patch	8.4T. Main		\$
	Tap by Gifford			\$
			11-9-55	\$
	O'head			\$
				\$ 27.02

Last Lot ON North Side West

St-  
Pl-  
James Court Ave. No. 9

Name of Owner  
Cafaro

Labor and Mat'l. Report Nov. 9 1955

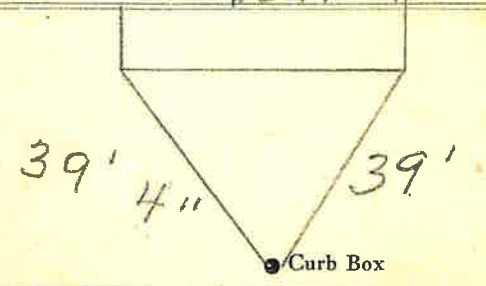

6" Main Elev. of Main at tap 5 1/2'

Gate at • Gate at

26' to MAIN

• Curb Box

Use Long Wrench to Turn ON & OFF.