

LABOR AND MATERIALS

1	Copper	Connection	3/4"	\$	
1	Lead	Cock	3/4 in.	\$	
1	Curb	Valve		\$	
		T.S. & V.		\$	
1	Service box	Short 3 1/2 x 4 1/2		\$	
	Old returned	Long 4 1/2 x 5 1/2		\$	
		Buff or Rdway		\$	
15	Ft.	3/4 in.	Copper	Pipe at	\$
			G.I.		\$
			G.I.		\$
	Nipples	in.	at	\$	
	Bushings	to	in. at	\$	
	Red'g			\$	
	Inc'g	Coupl'gs.	to in. at	\$	
	Union	in.	at	\$	
	Meter	in.	at	\$	
	Lead Joints	at		\$	
	Compound Joints	at		\$	
	Maintenance Foreman			\$	
	Hrs. Water Maint. Man	1 at		\$	
	Hrs. Water Maint. Man	2 at		\$	
	Hrs. Garage Foreman	at		\$	
	Hrs. Labor	at		\$	
	Hrs. Compressor	at		\$	
	Compensation Ins.	at \$	per C	\$	
	Trucking			\$	
	Pav't Patch			\$	
	Tap by Gifford & Co			\$	
		7-17-68.		\$	
	O'head			\$	

CT.  
St.  
Pl.  
Ave. No. 10

James

Name of Owner

Wm + Dorothy Meeker

Labor and Mat'l. Report July 17 1956

Lot Tap.

● Curb Box


6" Main

Elev. of Main at tap 5'

Gate at ●

● Gate at

15' to MAIN

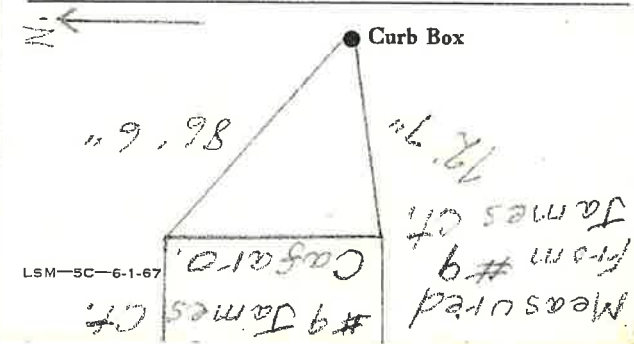

LSM-5C-6-1-67

Measured from #9 James Ct. to #9 James Ct. 72.7"

Measured  
from #9  
James Ct.

#9 James Ct.  
Casaro.

LSM-SC-6-1-67

72.7"

99.8"

● Curb Box



15' to Main

● Gate at

● Gate at

Elev. of  
Main at tap

6" Main

● Curb Box

Lot Tap:

Labor and Mat'l. Report July 17 1956

Name of Owner  
Wm + Dorothy Meehan

James  
Ct.  
St.  
Pt.  
Ave. No. 10