


LABOR AND MATERIALS

Copper	} Connection	_____	\$ _____	
Lead				
Curb	} Cock } Valve } T. S. & V.	_____ in.	\$ _____	
Service box		} Short 3½ x 4½ } Long 4½ x 5½	_____	\$ _____
Old returned				\$ _____
11 Ft. ¾ in.	} Copper } G.I. } C.I.	Pipe at _____	\$ _____	
Nipples		_____ in. at _____	\$ _____	
Bushings	_____ to _____ in.	at _____	\$ _____	
Red'g Inc'g	} Coupl'gs	_____ to _____ in.	at _____ \$ _____	
Union		_____ in. at _____	\$ _____	
Meter	_____ in. at _____	\$ _____		
Compound Joints	at _____	\$ _____		
Maintenance Foreman	_____	\$ _____		
Hrs. Water Maint. Man-1	at _____	\$ _____		
Hrs. Water Maint. Man-2	at _____	\$ _____		
Hrs. Garage Foreman	_____ at _____	\$ _____		
Hrs. Labor	_____ at _____	\$ _____		
Hrs. Compressor	at _____	\$ _____		
Trucking	_____	\$ _____		
Pav't Patch	_____	\$ _____		
		\$ _____		
		\$ _____		
		\$ _____		
		\$ _____		

JAMES _____
 CT. St. Pt. Ave. No. 16

Name of Owner
 Dennis Weber

Labor and Mat'l. Report 19 90

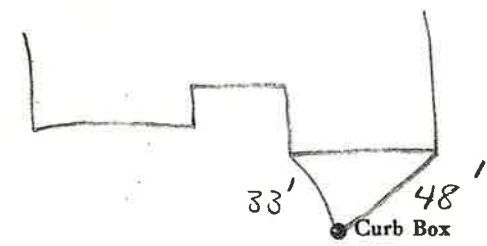

6" Main Elev. of Main at top 6 ½'

Gate at • Gate at

11' to main

• Curb Box