

LABOR AND MATERIALS

1 Copper Lead	} Connection	3/4		\$ 1.59
1 Curb	{ Clock Valve T.S. & V. }	3/4	in.	\$ 2.74
Service box Old returned	{ Short 3 1/2 X 4 1/2 Long 4 1/2 X 5 1/2 Buff or Rdway	Same		\$ —
12 Ft. 3/4 in.	{ Copper Galv. Iron Cast Iron	19	Pipe at	\$ 2.28
Nipples	in. at			\$
Bushings	to in. at			\$
Red'g Inc'g	{ Couplings	to	in. at	\$
Union	in. at			\$
Meter	in. at			\$
Lead Joints	at			\$
Compound Joints	at			\$
Hrs. Foreman	at			\$
Hrs. Chauffeur	at			\$
9 Hrs. Tapper	at	6.9314		\$ 6.19
11 Hrs. Labor	at	6.0		\$ 6.60
Hrs. Labor	at			\$
1 Hrs. Compressor	at	8.71x		\$ 88
Compensation Ins.				\$ 39
Trucking				\$ 1.29
Builders Use of Water				\$ 5.—
Tap by Hessel				\$
				\$
				\$
				\$
				\$
				\$ 26.67


70-45

St. 21
Pl. 6
Ave. No. 6

Jay

Name of Owner Maintenance

Labor and Mat'l. Report Aug 2 1945

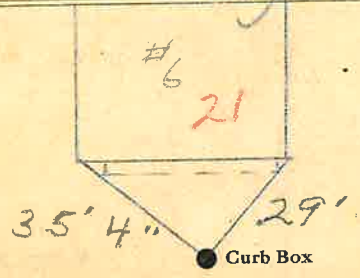

4 Main Elev. of Main at tap 6

Gate at ● 8-11-60. Gate at ●
shut off at curb.
To be dug up at main.

● Curb Box
House Razed.