

LABOR AND MATERIALS

1	Copper	Connection	$\frac{3}{4}$ "					\$ 2.76
	Lead							
1	Curb	Cock Valve	$\frac{3}{4}$ in.					\$ 3.49
		T. S. & V.						
1	Service box	Old returned	Short $3\frac{1}{2} \times 4\frac{1}{2}$					\$ 4.74
			Long $4\frac{1}{2} \times 5\frac{1}{2}$					
			Buff or Rdway.					\$ 6.32
14	Ft.	$\frac{3}{4}$ in.	Copper	Pipe at	38			\$ 5.32
			G. I.					
			G. I.					
	Nipples	in. at						\$
	Bushings	to in. at						\$
	Red'g							\$
	Inc'g	Coupl'gs to in. at						\$
	Union	in. at						\$
	Meter	in. at						\$
	Lead Joints	at						\$
	Compound Joints	at						\$
	Hrs. Water Maint. Man-1	at						\$
8	Hrs. Water Maint. Man-2	at	1.24					\$ 9.92
18	Hrs. Labor	at	1.13					\$ 20.34
	Hrs. Labor	at						\$
	Hrs. Compressor	at						\$
	Compensation Ins.	at \$4.406 per C						\$ 1.33
	Trucking							\$ 1.00
	Pav't Patch							\$ 6.75
	Tap by Gifford	10-23-53						\$
	O'head							\$
								\$ 5.565

48.90


78-53

St. _____
 -Plr _____
 Ave. No. 25

Jay

Name of Owner Caiazza

Labor and Mat'l. Report Oct 23 1953

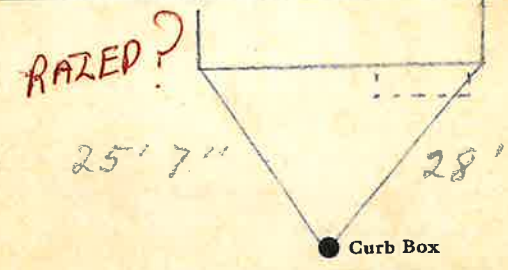

4" Main Elev. of Main at tap 6'

Gate at ● ● Gate at

● Curb Box