

LABOR AND MATERIALS

Copper	} Connection _____	\$ _____	
Lead			
Curb	} Cock } Valve } T. S. & V. }	in. _____ \$ _____	
Service box			} Short 3½ x 4½ } } Long 4½ x 5½ }
Old returned			
Ft. _____ in.	{ Copper } G. I. } C. I. }	Pipe at _____ \$ _____	
Nipples _____	in. at _____	\$ _____	
Bushings _____	to _____ in. at _____	\$ _____	
Red'g } Inc'g }	} Coupl'gs _____ to _____ in. at _____	\$ _____	
Union _____			in. at _____ \$ _____
Meter _____	in. at _____	\$ _____	
Compound Joints at _____		\$ _____	
Maintenance Foreman _____		\$ _____	
Hrs. Water Maint. Man—1 at _____		\$ _____	
Hrs. Water Maint. Man—2 at _____		\$ _____	
Hrs. Garage Foreman _____ at _____		\$ _____	
Hrs. Labor— _____ at _____		\$ _____	
Hrs. Compressor at _____		\$ _____	
Trucking _____		\$ _____	
Pav't Patch _____		\$ _____	
_____		\$ _____	
_____		\$ _____	

Near Deal End

St. _____
~~Pl.~~ _____
 Ave. No. _____

Jay

 Name of Owner _____

Labor and Mat'l. Report _____ 19 _____

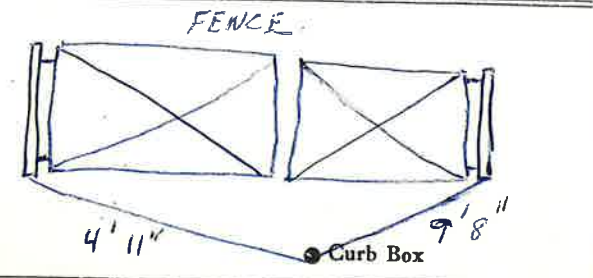

_____ Main Elev. of
 Main at tap _____

Gate at ● ● Gate at

● Curb Box

Garden Pipe