


LABOR AND MATERIALS

Copper	} Connection	_____	\$ _____	
Lead				
Curb	} Cock } Valve } T.S. & V. }	_____ in.	\$ _____	
Service box		{ Short 3½ x 4½ } Long 4½ x 5½ } Buff or Rdway }	_____	\$ _____
Old returned				
24 Ft. ¾ in.	{ Copper } <del>G.I.</del> } <del>G.I.</del>	Pipe at	\$ _____	
Nipples	in. at	_____	\$ _____	
Bushings	to _____ in. at	_____	\$ _____	
Red'g } Inc'g }	Coupl'gs	to _____ in. at	\$ _____	
Union	in. at	_____	\$ _____	
Meter	in. at	_____	\$ _____	
Lead Joints	at	_____	\$ _____	
Compound Joints	at	_____	\$ _____	
Maintenance Foreman		_____	\$ _____	
Hrs. Water Maint. Man-1	at	_____	\$ _____	
Hrs. Water Maint. Man-2	at	_____	\$ _____	
Hrs. Garage Foreman	at	_____	\$ _____	
Hrs. Labor	at	_____	\$ _____	
Hrs. Compressor	at	_____	\$ _____	
Compensation Ins. at \$	per C	_____	\$ _____	
Trucking		_____	\$ _____	
Pav't Patch		_____	\$ _____	
		_____	\$ _____	
		_____	\$ _____	
O'head		_____	\$ _____	
		_____	\$ _____	

St. \_\_\_\_\_  
~~Pl.~~  
 Ave. No. 9

Jefferson  
 Name of Owner \_\_\_\_\_  
Samchuk

Labor and Mat'l. Report \_\_\_\_\_ 1986

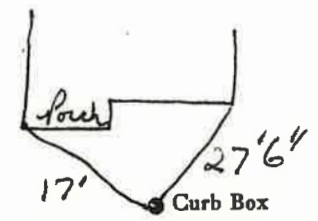

\_\_\_\_\_ Main Elev. of Main at tap \_\_\_\_\_  
 Gate at • \_\_\_\_\_ Gate at \_\_\_\_\_  
24' to main  
¾ copper • Curb Box