

### LABOR AND MATERIALS

1	Copper <del>Lead</del>	Connection	$\frac{3}{4}$	\$ 1.23
1	Curb	Cock Valve T.S. & V.	$\frac{3}{4}$ in.	\$ 1.68
1	Service Box Old returned	Short $3\frac{1}{2} \times 4\frac{1}{2}$ Long $4\frac{1}{2} \times 5\frac{1}{2}$ Buff. or Rdway		\$ 1.75
23	Ft.	$\frac{3}{4}$ in.	Copper Galv Iron Cast iron	\$ 3.45
	Nipples	in. at		\$
	Bushings	to in. at		\$
	Red'g Inc'g	Couplings	to in. at	\$
	Union	in. at		\$
	Meter	in. at		\$
	Lead Joints	at		\$
	Leadite Joints	at		\$
	Hrs. Foreman	at		\$
3	Hrs. Chauffeur	at	62 1/2	\$ 1.88
3	Hrs. Tapper	at	-	\$ 1.87
6	Hrs. Labor	at	45	\$ 2.70
	Hrs. Labor	at		\$
	Hrs. Compressor	at		\$
	Compensation Ins.			\$ 20
	Trucking			\$ 1.-
	Builders Use of Water			\$
	Tap by Messell			\$
				\$
				\$
				\$
				\$
				\$ 15.76

155 - 1938

St. 11

~~Pl~~

Ave. No. 7


Name of Owner

Eddy

Labor and Mat'l. Report

Nov 12

1938

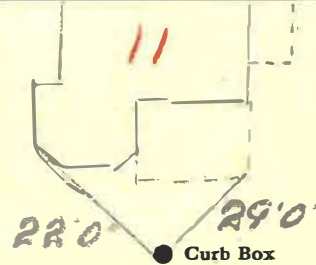

6 Main

Elev. of

Main at tap

5

Gate at ●

● Gate at

● Curb Box

old shut off

Tax ID# 302.16.11.30