

LABOR AND MATERIALS

1 Copper Lead	{ Connection	$\frac{3}{4}$	\$	1.23	
1 Curb	{ Cock Valve T.S. & V.	$\frac{3}{4}$ in.	\$	1.68	
1 Service Box	{ Short $3\frac{1}{2} \times 4\frac{1}{2}$ Long $4\frac{1}{2} \times 5\frac{1}{2}$ Buff. or Rdway		\$	1.75	
Old returned					
11 Ft.	$\frac{3}{4}$ in.	{ Copper Galv Iron Cast Iron	Pipe at	\$	1.65
Nipples	in.	at	\$		
Bushings	to	in.	at	\$	
Red'g Inc'g	{ Couplings	to	in.	at	\$
Union	in.	at	\$		
Meter	in.	at	\$		
Lead Joints	at		\$		
Leadite Joints	at		\$		
Hrs. Foreman	at		\$		
2 $\frac{1}{2}$ Hrs. Chauffeur	at		\$	1.56	
2 $\frac{1}{2}$ Hrs. Tapper	at		\$	1.57	
7 $\frac{1}{2}$ Hrs. Labor	at		\$	3.38	
Hrs. Labor	at		\$		
Hrs. Compressor	at		\$		
Compensation Ins.			\$.20	
Trucking			\$	1.00	
Builders Use of Water	no patch (B.P.)		\$		
Tapped Hessel			\$		
			\$		
			\$		
			\$		
			\$		
			\$	14.02	

154-1938

St. 12

Pl:


Ave. No. 4

Jefferson
Name of Owner

Albert Koch

Labor and Mat'l. Report

Nov 12 1924

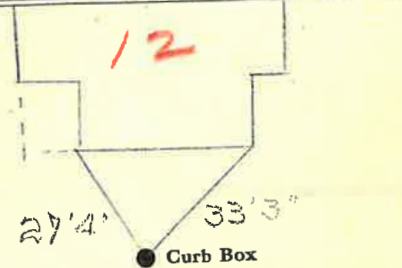

6 Main Elev. of Main at tap 5
Gate at ● Gate at ●

● Curb Box

old shut off