

Labor and Materials

1	Copper	Lead	Connection	7		\$ 2.70
1	Curb	Cock Valve		4	3	\$ 2.34
			F.S. & V.			
1	Service Box	Short	3 1/2 x 4 1/2			\$ 1.45
	Old returned	Long	4 1/2 x 5 1/2			
			Buff. or Rdway			
22	Ft.	in.	Copper	3		\$ 5.94
			Galv. Iron	1		
			Cast Iron			
	Nipples	in.	at			\$
	Bushings	to	in. at			\$
	Red'g	Inc'g	Couplings	to	in. at	\$
	Union	in.	at			\$
	Meter	in.	at			\$
	Lbs. Br. Stone	at				\$
	Lbs. Sand	at				\$
	Bags Cement	at				\$
	Paving Brick	Mack	at			\$
		Red				\$
		Asphalt				\$
	Lead Joints	at				\$
	Leadite Joints	at				\$
3	Hrs.	Foreman	at			\$ 1.88
16	Hrs.	Common Labor	at			\$ 7.20
	Hrs.	Common Labor	at			\$
	Hrs.	Mason	at			\$
	Hrs.	Mason's Helper	at			\$
	Hrs.	Compressor	at			\$
	Compensation	Ins				\$ 28
	Trucking					\$ 1.-
	Builders' Use of Water	Patch				\$ 5.-
Total \$						27.84

30-48


13

Labor and Material Report

May

22 1930

9 Jefferson at

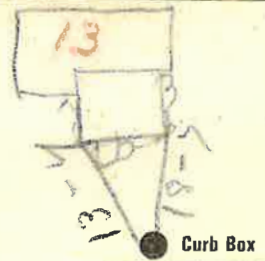

6 Main

Elev of Main at tap 5 1/2

Gate at ●

TAX ID # 302.16-1-29

● Gate at

● Curb Box

Old tap to be shut off

Tax ID # 302.16-11-29