

LABOR AND MATERIALS


1 Copper	} Connection	3/4	-----	\$ 1.23
1 Lead				
1 Curb	} Cock Valve T. S. & V.	3/4	in. -----	\$ 1.65
1 Service Box				
Old returned	} Short 3 1/2 x 4 1/2 Long 4 1/2 x 5 1/2 Buff. or Rdway		-----	\$ 1.75
23 Ft. 3/4 in.				
Nipples	in. at		-----	\$
Bushings	to	in. at	-----	\$
Red'g Inc'g	} Couplings	to	in. at	-----
Union	in. at		-----	\$
Meter	in. at		-----	\$
Lead Joints	at		-----	\$
Leadite Joints	at		-----	\$
Hrs. Foreman	at		-----	\$
2 1/2 Hrs. Chauffeur	at		-----	\$ 1.56
2 1/2 Hrs. Tapper	at		-----	\$ 1.57
2 1/2 Hrs. Labor	at		-----	\$ 3.38
Hrs. Labor	at		-----	\$
Hrs. Compressor	at		-----	\$
Compensation Ins.			-----	\$ 20
Trucking			-----	\$ 1.00
Builders Use of Water	(Hospital) @ P		-----	\$
Taphy Hessell			-----	\$
			-----	\$
			-----	\$
			-----	\$
			-----	\$ 15.92

1 5 7 - 1938

St. 17
Pl. -----
Ave. No. 13

Jefferson
Name of Owner
Clifford Floyd

Labor and Mat'l. Report Nov 14 1938

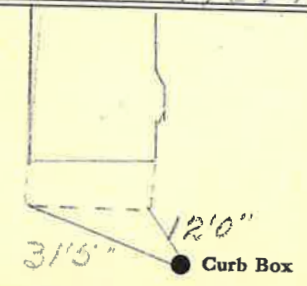

6 Main Elev. of Main at tap 5

Gate at ● Gate at ●

TAX ID # 302.16-11-27

● Curb Box

for old shut off