


Labor and Materials

Copper } Connection.....	3	\$ 1.33
Lead } Connection.....	4	
Curb { Cock Valve }	3	\$ 1.58
{ T.S. & V. }	4	
Service Box { Short 3 1/2 x 4 1/2 }		\$ 1.36
Old returned { Long 4 1/2 x 5 1/2 }		
{ Buff. or Redway }		
24 Ft. 3/4 in. { Copper Galv. Iron } Pipe at		\$ 2.28
{ Cast Iron }		
Nipples		\$
Bushings		\$
Red'g } Couplings..... to..... in. at		\$
Inc'g }		
Union..... in. at		\$
Meter..... in. at		\$
Lbs. Br. Stone at		\$
Lbs. Sand at		\$
Bags Cement at		\$
Paving Brick { Mack Red Asphalt } at		\$
Lead Joints at		\$
Leadite Joints at		\$
3 Hrs. Foreman at		\$ 1.88
9 Hrs. Common Labor at		\$ 4.50
10 Hrs. Common Labor at		\$ 4.50
Hrs. Mason at		\$
Hrs. Masons Helper at		\$
Hrs. Compressor at		\$
Compensation Ins		\$ 1.33
Trucking		\$
Builders Use of Water Patch		\$ 5.00
Total \$		73.76

1 John St

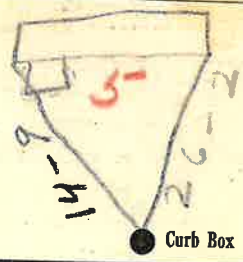

6 Main Elev. of Main at tap 5
Gate at ● Gate at ●

● Curb Box

old Tap shut off
at Main

270