
Labor and Materials    Copper } Connection  3    Lead  \$    Copper  \$    Mission  \$    Long  \$    Long  \$    Did returned  Long    Buff or Relwary  \$    1
Copper } Connection  3  \$.2.60
4Curb {Cock Value  inin.  3.2.71   4Service Rox {Short 35x14/s  +1  5.2.71   4Service Rox {Short 35x14/s  +1  5.1.59    Old returned {Dorg 45x55/s  \$.1.59   4Ftin. {Copper Galve from Cast from Pipe at
Old returned    Long 4% x5%    \$    1.59      Old returned    Buff or Rdway    \$    \$    1.98      11 Ftin.    Galv stron    Pipe at
-/+Ftin. {Copper Galve fron Pipe at
Red'g Couplings
Unionin. at
Lbs. Br. Stone at
Lbs. Sand at
Paving Brick Mack Asphalt at
Lead Joints at\$
Leadite Joints at
.V. Hrs. Common Labor at.
Hrs Mason's Helper at
Ĥrs. Compressor at
Builders' Use of Water Patch
S. S
Total \$23.33
and the second

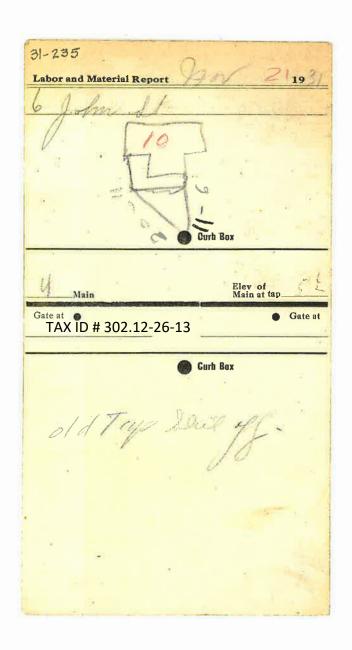

20' 11" 11' 6"