

LABOR AND MATERIALS

1	Copper	} Connection	3/4"	\$
1	Curb		} 3/4 in. (MARKED CRISPER)	\$
1	Service box	} Street 4 1/2		Same Box
	Old returned		} Long 4 1/2 x 5 1/2	
11	Ft. 3/4 in.	} Copper		} Pipe at
			} 3/4 in.	
	Nipples	in. at		\$
	Bushings	to in. at	\$	
	Red'g	} Coupl'gs	to in. at	\$
	Inc'g			
	Union	in. at	\$	
	Meter	in. at	\$	
	Lead Joints	at	\$	
	Compound Joints	at	\$	
	Maintenance Foreman		\$	
	Hrs. Water Maint. Man-1	at	\$	
	Hrs. Water Maint. Man-2	at	\$	
	Hrs. Garage Foreman	at	\$	
	Hrs. Labor	at	\$	
	Hrs. Compressor	at	\$	
	Compensation Ins. at \$	per C	\$	
	Trucking		\$	
	Pav't Patch		\$	
	Tap Made B St John		\$	
	JAN-16-1975		\$	
	O'head		\$	

John


St. Ave. No. 14

Name of Owner

Daley

Labor and Mat'l. Report

JAN 16 1975

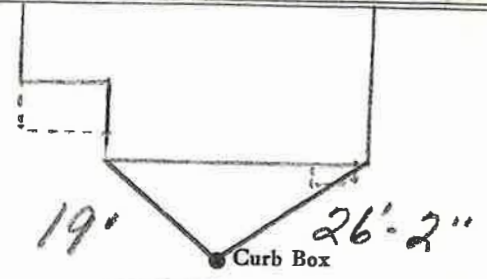

6" Main

Elev. of Main at tap 5 1/2'

Gate at ●

● Gate at

TAX ID # 302.12-26-15

● Curb Box