

LABOR AND MATERIALS

Copper Lead } Connection		\$	3.20
<u>3/4</u> Curb } Cock Valve T.S. & V. }	in.	\$	1.00
Service box Old returned { Short 3-1/2 x 4-1/2 Long 4-1/2 x 5-1/2 }		\$	1.76
<u>8</u> Ft. <u>3/4</u> in. { Copper G.I. C.I. }	Pipe at	\$	1.76
<u>1</u> Nipples	in. at	\$.12
<u>1</u> Bushings	to in. at	\$.08
<u>1</u> Red'g			.18
Inc'g			
Union	in. at	\$	
Meter	in. at	\$	
Compound Joints at		\$	
<u>1 HRS</u> Maintenance Foreman	.50	\$.50
<u>6</u> Hrs. Water Maint. Man - 1 at	.41	\$	2.44
Hrs. Water Maint. Man - 2 at		\$	
Hrs. Garage Foreman	at	\$	
Hrs. Labor	at	\$	
Hrs. Compressor at		\$	
Trucking		\$	1.00
Pav't Patch		\$.08
		\$	
		\$	
		\$	
		\$	
		\$	10.36
		\$	


JUVET

St.
Pl.
Ave. No.

3

Name of Owner

Labor and Mat'l. Report 19 25 -- OCT 14TH

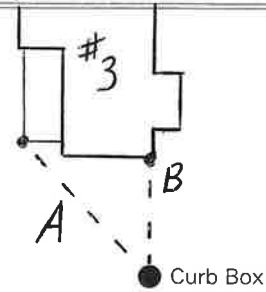

4" Main

Elev. of Main at tap 5'

Gate at ●

● Gate at

● Curb Box

$$A = 31'8''$$

$$B = 13'$$

