

LABOR AND MATERIALS

1	Copper	{ Connection	3/4"		\$ 3.04
	Lead				
1	Curb	{ Cock Valve F.S. & V. }	3/4 in.		\$ 3.54
Same	Service box	{ Short 3 1/2 x 4 1/2			
	Old returned	{ Long 4 1/2 x 5 1/2			
		{ Buff. or Rdway			
7	Ft.	{ Copper G.I. C.I. }	3/4 in.	Pipe at 35	\$ 2.45
	Nipples	in. at			
1	Bushings	3/4 to 1/2 in. at			\$ 30
	Red'g	{ Coupl'gs	to	in. at	
	Inc'g				
	Union	in. at			
	Meter	in. at			
	Lead Joints at				
	Compound Joints at				
2	Hrs. Water Maint. Man—1 at	1.25			\$ 2.46
	Hrs. Water Maint. Man—2 at				
10	Hrs. Labor—	at 1.02			\$ 10.20
	Hrs. Labor—	at			
	Hrs. Compressor at				
	Compensation Ins. at \$2665 per C.				\$ 34
	Trucking				\$ 1.00
	Pav't Patch				\$ 8.10
	Tap by Miller 9-11-51				
	O'head				
					\$ 31.43

102-1020

Juvet


St. ~~Pt.~~
Ave. No. 7

Name of Owner

Murray

Labor and Mat'l. Report

Sept. 11 1951

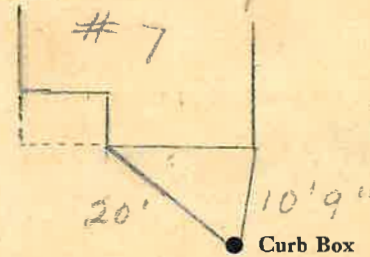

4" Main

Elev. of Main at tap 5'

Gate at ●

● Gate at

TAX ID # 309.12-9-15

● Curb Box

Old tap disconnected.