

LABOR AND MATERIALS

Copper	} Connection	_____	\$ _____	
Lead				
Curb	} Cock } Valve } T. S. & V. }	_____ in.	\$ _____	
Service box		} Short 3½ x 4½ } Long 4½ x 5½ }	_____	\$ _____
Old returned				
20 ¹ / ₃₄ Ft.	} Copper } G. I. } G. I. }	_____ in.	\$ _____	
Nipples	_____ in.	at _____	\$ _____	
Bushings	_____ to _____	in. at _____	\$ _____	
Red'g Inc'g	} Coupl'gs	_____ to _____	in. at _____	\$ _____
Union		_____ in.	at _____	\$ _____
Meter	_____ in.	at _____	\$ _____	
Compound Joints	at _____		\$ _____	
Maintenance Foreman			\$ _____	
Hrs. Water Maint. Man	—1 at _____		\$ _____	
Hrs. Water Maint. Man	—2 at _____		\$ _____	
Hrs. Garage Foreman	at _____		\$ _____	
Hrs. Labor	— at _____		\$ _____	
Hrs. Compressor	at _____		\$ _____	
Trucking			\$ _____	
Pav't Patch			\$ _____	
			\$ _____	
			\$ _____	
JUVET

St. 8
Pl. _____
Ave. No. _____

Name of Owner _____

Labor and Mat'l. Report

19 96

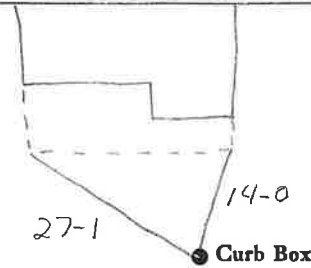

4" Main

Elev. of Main at tap 4'

Gate at •

• Gate at

• Curb Box