


Labor and Materials

1	Copper	Connection	\$ 1.50
1	Lead		
1	Curb	Cock Valve T.S.&V.in	\$ 1.70
1	Service Box	Short 3 1/2 x 4 1/2	}	\$ 1.44
	Old returned	Long 4 x 5 1/2		
8	Ft.	3/4 in. Copper Galv. Iron Cast Iron Pipe at	\$ 1.52
	Nipplesin. at	\$
	Bushingsto	in. at	\$
	Red'g Inc'g	Couplingsto	in. at \$
	Unionin. at	\$
	Met'r.in. at	\$
	Lbs. Br. Stone	at	\$
	Lbs. Sand	at	\$
	Bags Cement	at	\$
	Paving Brick	Mack Red Asphalt } at	\$
	Lead Joints	at	\$
	Leadite Joints	at	\$
3	Hrs. Foreman	at	6.2 hr	\$ 1.88
4	Hrs. Common Labor	at	50	\$ 2.00
4	Hrs. Common Labor	at	45	\$ 1.80
	Hrs. Mason	at	\$
	Hrs. Masons Helper	at	\$
	Hrs. Compressor	at	\$
	Compensation Ins		\$ 0.20
	Trucking		\$ 1.00
	Builders Use of Water	Paint Patch	\$ 5.00
Total \$				18.04

17 34

Labor and Material Report *May 10 1934*

9 Street St

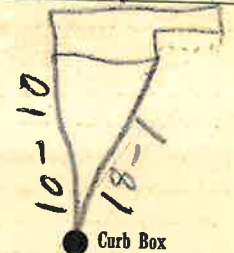

4 Main Elev. of Main at tap *5*

Gate at ● Gate at ●

● Curb Box

old lay. start off at main

MM