

LABOR AND MATERIALS

1	Copper	} Connection	3/4"	\$	_____				
	Lead								
7	Curb	} Cock Valve T.S. & V.	} 3/4 in.	\$	_____				
1	Service box					} Short 3 1/2 x 4 1/2	}	\$	_____
	Old returned								
24	Ft. 3/4 in.	} Copper G.I. C.I.	} Pipe at	\$	_____				
	Nipples	in. at		\$	_____				
	Bushings	to in. at		\$	_____				
	Red'g Inc'g	} Coupl'gs	to in. at	\$	_____				
	Union	in. at		\$	_____				
	Meter	in. at		\$	_____				
	Lead Joints	at		\$	_____				
	Compound Joints	at		\$	_____				
	Maintenance Foreman			\$	_____				
	Hrs. Water Maint. Man-1	at		\$	_____				
	Hrs. Water Maint. Man-2	at		\$	_____				
	Hrs. Garage Foreman	at		\$	_____				
	Hrs. Labor	at		\$	_____				
	Hrs. Compressor	at		\$	_____				
	Compensation Ins. at \$	per C		\$	_____				
	Trucking			\$	_____				
	Pav't Patch			\$	_____				
	Tap by Gissard			\$	_____				
	+ Cb. 7-20-60			\$	_____				
	O'head			\$	_____				
				\$	_____				


Juvet

St. 10 1/2  
Pl. 10 1/2  
Ave. No.

Name of Owner

Murphy

Labor and Mat'l. Report July 21 1960

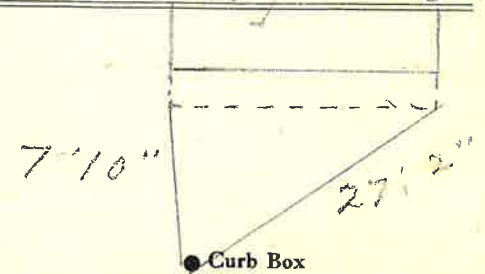

4" Main

Elev. of Main at tap 5'

Gate at •

• Gate at

• Curb Box