


LABOR AND MATERIALS

Copper } Connection _____ \$ _____
 Lead }
 Curb } Cock } _____ in. \$ _____
 } Valve }
 } T.S. & V. }
 Service box { Short 3-1/2 x 4-1/2 } _____ \$ _____
 Old returned { Long 4-1/2 x 5-1/2 }
 15+ Ft. in. { Copper } Pipe at _____ \$ _____
 } G.I.
 } C.I.
 Nipples _____ in. at _____ \$ _____
 Bushings _____ to _____ in. at _____ \$ _____
 Red'g _____
 Inc'g _____
 Union _____ in. at _____ \$ _____
 Meter _____ in. at _____ \$ _____
 _____ \$ _____
 Compound Joints at _____ \$ _____
 Maintenance Foreman _____ \$ _____
 Hrs. Water Maint. Man - 1 at _____ \$ _____
 Hrs. Water Maint. Man - 2 at _____ \$ _____
 Hrs. Garage Foreman _____ at _____ \$ _____
 Hrs. Labor _____ at _____ \$ _____
 Hrs. Compressor at _____ \$ _____
 _____ \$ _____
 Trucking _____ \$ _____
 Pav't Patch _____ \$ _____
 _____ \$ _____
 _____ \$ _____
13 Katherine
 St. _____
 Pl. _____
 Ave. No. _____

Name of Owner _____

Labor and Mat'l. Report ~~10~~ 2003 3/31/03

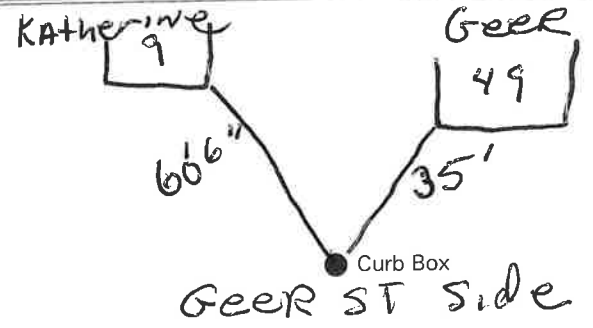

_____ Main
 Elev. of Main at tap _____

Gate at ● Gate at ●
 SEWER CLEAN OUT + CURB BOX ARE TOGETHER.

● Curb Box
 WATER + SEWER
 Geer ST side
 3 Feet Deep AT CURB BOX