


LABOR AND MATERIALS

1	Copper Lead	Connection	3/4"	\$	
1	Curb	Cock Valve T.S. & V.	3/4" in.	\$	
1	Service box Old returned	Short 3 1/2 x 4 1/2 Long 4 1/2 x 5 1/2		\$	
26	Ft.	3/4" in. Copper C.I. C.I.	Pipe at	\$	
	Nipples	in. at		\$	
	Bushings	to in. at		\$	
	Red'g Inc'g	Coupl'gs	to in. at	\$	
	Union	in. at		\$	
	Meter	in. at		\$	
	Compound Joints	at		\$	
	Maintenance Foreman			\$	
	Hrs. Water Maint. Man-1	at		\$	
	Hrs. Water Maint. Man-2	at		\$	
	Hrs. Garage Foreman	at		\$	
	Hrs. Labor	at		\$	
	Hrs. Compressor	at		\$	
	Trucking			\$	
	Pav't Patch			\$	
				\$	
				\$	
St. Pt. Ave. No. 2
 KATHERINE
 Name of Owner
 ANDREW DEJONGHORE
 Labor and Mat'l. Report Nov. 1937

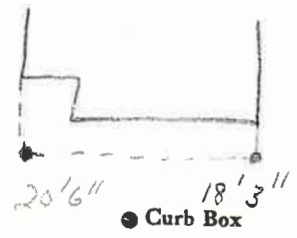

12" Main (1969) Elev. of Main at tap 5' to 6'
 Gate at • Gate at
 TAX ID # 303.18-2-23
 • Curb Box

20' 6" 18' 3"
 12" Main 1969 5' to 6'