


LABOR AND MATERIALS

1	Copper Lead	} Connection $\frac{3}{4}$ "	\$
1	Curb		} Cock Valve T.S. & V. } $\frac{3}{4}$ " in.
1	Service box Old returned	} Short $3\frac{1}{2}$ x $4\frac{1}{2}$ Long $4\frac{1}{2}$ x $5\frac{1}{2}$ }	
26	Ft. $\frac{3}{4}$ " in.		} Copper G.I. G.I. }
	Nipples	in. at \$	
	Bushings	to in. at \$	
	Red'g Inc'g }	} Coupl'gs to in. at \$	
	Union		in. at \$
	Meter	in. at \$	
	Compound Joints	at \$	
	Maintenance Foreman	\$	
	Hrs. Water Maint. Man—1	at \$	
	Hrs. Water Maint. Man—2	at \$	
	Hrs. Garage Foreman	at \$	
	Hrs. Labor—	at \$	
	Hrs. Compressor	at \$	
	Trucking	\$	
	Pav't Patch	\$	
		\$	
		\$	
St. KATHERINE
 -Pl. 4
 Azor No. 4

Name of Owner
JOHN KEENE

Labor and Mat'l. Report NOV 19 37

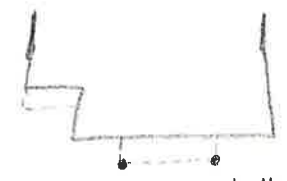

15'5" 21'6"
 ● Curb Box

12" Main (1969) Elev. of Main at tap 5'10.6'

Gate at ● Gate at

● Curb Box