


LABOR AND MATERIALS

BRASS			
1	Copper } Connection		\$
	Lead }		
1	Curb } Cock		\$
	Valve }	in.	
	T.S. & V.		
1	Service box } Short 3 1/2 x 4 1/2		\$
	Old returned } Long 4 1/2 x 5 1/2		
26	Ft. 3/4 in. } Copper		\$
	} C.I.	Pipe at	
	Nipples	in. at	\$
	Bushings	to in. at	\$
1	<del>Red</del> } Coupl'gs BRASS	to in. at	\$
	Inc'g }		
	Union	in. at	\$
	Meter	in. at	\$
			\$
	Compound Joints	at	\$
	Maintenance Foreman		\$
	Hrs. Water Maint. Man-1	at	\$
	Hrs. Water Maint. Man-2	at	\$
	Hrs. Garage Foreman	at	\$
	Hrs. Labor	at	\$
	Hrs. Compressor	at	\$
			\$
	Trucking		\$
	Pav't Patch		\$
			\$
			\$
St. KATHERINE  
 Pl. 6  
 Ave. No. 6

Name of Owner \_\_\_\_\_

Labor and Mat'l. Report OCT. 19 25

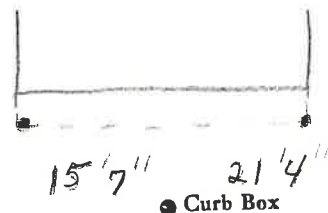

12'' Main (1967) Elev. of Main at tap 5'8.6'

Gate at ● Gate at ●

● Curb Box