


LABOR AND MATERIALS

1	Copper Lead	Connection	3/4"	\$	_____
1	Curb	Cock Valve T.S. & V.	3/4" in.	\$	_____
1	Service box Old returned	Short 3 1/2 x 4 1/2 Long 4 1/2 x 5 1/2		\$	_____
26	Ft.	3/4" in. Copper C.I. C.I.	Pipe at	\$	_____
	Nipples	in. at		\$	_____
	Bushings	to in. at		\$	_____
	Red'g Inc'g	Coupl'gs to in. at		\$	_____
	Union	in. at		\$	_____
	Meter	in. at		\$	_____
	Compound Joints	at		\$	_____
	Maintenance Foreman			\$	_____
	Hrs. Water Maint. Man	1 at		\$	_____
	Hrs. Water Maint. Man	2 at		\$	_____
	Hrs. Garage Foreman	at		\$	_____
	Hrs. Labor	at		\$	_____
	Hrs. Compressor	at		\$	_____
	Trucking			\$	_____
	Pav't Patch			\$	_____
				\$	_____
				\$	_____
				\$	_____
				\$	_____

St. Pt. Ave. No. 8
KATHERINE

Name of Owner
PREVOST

Labor and Mat'l. Report NOV 1937

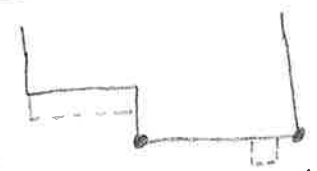

23'-10" 25'-8"
 ● Curb Box

12" Main (1969) Elev. of Main at tap 5.76'
 Gate at ● IRON MAIN ● Gate at

● Curb Box

OLD TAP DISCONNECTED