

LABOR AND MATERIALS

1	Copper Lead	Connection	3/4		\$ 1.23
1	Curb	Cock Valve T. S. & V.	3/4 in.		\$ 1.68
1	Service Box Old returned	Short 3 1/2 x 4 1/2 Long 4 1/2 x 5 1/2 Buff. or Rdway			\$ 1.54
11	Ft.	3/4 in.		Copper Galv-iron Cast-iron	Pipe at 17 \$ 1.87
	Nipples	in. at			\$
	Bushings	to in. at			\$
	Red'g Inc'g	Couplings	to in. at		\$
	Union	in. at			\$
	Meter	in. at			\$
	Lead Joints	at			\$
	Leadite Joints	at			\$
	Hrs. Foreman	at			\$
7	Hrs. Chauffeur	at	6 2/2		\$ 1.25
6	Hrs. Tapper	at	"		\$ 3.75
8	Hrs. Labor	at	4 5		\$ 3.60
	Hrs. Labor	at			\$
	Hrs. Compressor	at			\$
	Compensation Ins.				\$.26
	Trucking				\$ 1.-
	Builders Use of Water				\$
	Patch				\$ 5.00
					\$
					\$
					\$
					\$ 21.18

47 - 1939

St. 11
Pt.

Keenan


Ave. No. 6

Name of Owner

W.E. Hannan

Labor and Mat'l. Report

7-18-39 19

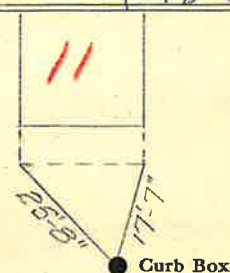

6" Main

Elev. of
Main at tap 6'

Gate at ●

● Gate at

● Curb Box