

Labor and Materials

1	Copper } Connection	3/4"	\$ 3.20
1	Lead } Connection	3/4"	\$ 1.00
1	Curb } Cock Valve } T.S. & V. }	in.	\$ 1.00
1	Service Box } Short 3' x 4' }		\$ 1.40
Old returned	Long 4' x 5' }		
14	Ft. } in. }	Copper Calv. Iron } Pipe at. 2.2	\$ 3.08
	Nipples	in. at.	\$
	Bushings	to in. at.	\$
	Red'g } Couplings	to in. at.	\$
	Inc'g }		\$
	Union	in. at.	\$
	Meter	in. at.	\$
	Lbs. Br. Stone	at.	\$
	Lbs. Sand	at.	\$
	Bags Cement	at.	\$
	Paving Brick } Mack Red Asphalt }	at.	\$
	Lead Joints	at.	\$
	Leadite Joints	at.	\$
6	Hrs. Foreman	at. 62.5	\$ 3.12
6	Hrs. Common Labor	at. 50	\$ 3.00
1	Hrs. Common Labor	at. 40 1/8	\$ 1.40
	Hrs. Mason	at.	\$
	Hrs. Mason's Helper	at.	\$
	Hrs. Compressor	at.	\$
	Compensation Ins.		\$ 18
	Trucking		\$ 100
	Builders' Use of Water		\$
Total			\$ 6.38

26-7


15

Labor and Material Report

Apr 26

1926

3/4" trap at 8 Kenner st

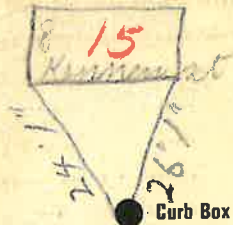

6" Main

Elev. of Main at tap 6.10

Gate at ●

● Gate at

● Curb Box