

Labor and Materials

Copper	{	Connection.....	\$	
Lead	}			
Curb	{	Cock Valve	in	\$
	}	T. S. & V.		
Service Box	{	Short 3 1/2 x 4 1/2	}	\$
Old returned		Long 4 1/2 x 5 1/2		
		Buff. or Rdway		
Ft.	in.	{ Copper Galv Iron Cast Iron }	Pipe at	\$
Nipples	in. at			\$
Bushings	to in. at			\$
Red'g Inc'g	{	Conplings..... to in. at		\$
Union	in. at			\$
Meter	in. at			\$
Lead Joints	at			\$
Leadite Joints	at			\$
Hrs. Foreman	at			\$
Hrs. Chauffeur	at			\$
Hrs. Tapper	at			\$
Hrs. Labor	at			\$
Hrs. Labor	at			\$
Hrs. Compressor	at			\$
Compensation Ins.				\$
Trucking				\$
Builders Use of Water				\$
				\$
				\$
St. 16
Pl. _____
Ave. No. 9

Keenan

Name of Owner _____

Labor and Mat'l. Report 19

16

.....Main	Elev. of Main at tap.....
Gate at ●	● Gate at

● Curb Box

LABOR AND MATERIALS

1	Copper Lead	} Connection 1"	\$
1	Curb } Cock Valve T. S. & V. }	1" in.	\$
1	Service Box Old returned	{ Short 3½x4½ Long 4½x5½ Buffer Rdway }	\$
24	Ft. 1"	{ Copper Galv Iron Cast Iron }	Pipe at \$
	Nipples	in. at	\$
	Bushings	to in. at	\$
	Red'g Inc'g }	Couplings to in. at	\$
	Union	in. at	\$
	Meter	in. at	\$
	Lead Joints at		\$
	Leadite Joints at		\$
	Hrs. Foreman at		\$
	Hrs. Chauffeur at		\$
	Hrs. Tapper at		\$
	Hrs. Labor at		\$
	Hrs. Labor at		\$
	Hrs. Compressor at		\$
	Compensation Ins.		\$
	Trucking		\$
	Builders Use of Water		\$
			\$
			\$
Tap by Hessel

50 1941

7915
St.
Pl.
Ave. No. 9

Keenan


Name of Owner

Sheehan

Labor and Mat'l. Report

Apr 23

1941

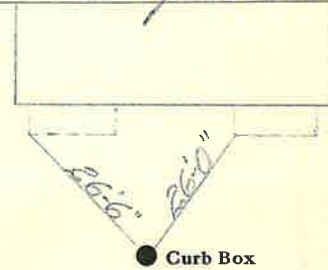

6" Main

Elev. of
Main at tap 5'

Gate at ●

● Gate at

● Curb Box

to be billed