

LABOR AND MATERIALS

1	Copper Lead	} Connection	3 1/4"	\$
1	Curb			
1	Service box	} Short 3 1/2 x 4 1/2	}	\$
1	Old returned			
13	3/4 in.	} Copper	} Pipe at	\$
	Nipples	in. at	\$	
	Bushings	to in. at	\$	
	Red'g Inc'g	Coupl'gs. to in. at	\$	
	Union	in. at	\$	
	Meter	in. at	\$	
	Lead Joints at		\$	
	Compound Joints at		\$	
	Maintenance Foreman		\$	
	Hrs. Water Maint. Man-1 at		\$	
	Hrs. Water Maint. Man-2 at		\$	
	Hrs. Garage Foreman at		\$	
	Hrs. Labor at		\$	
	Hrs. Compressor at		\$	
	Compensation Ins. at \$	per C	\$	
	Trucking		\$	
	Pay't Patch		\$	
	Top by Gifford		\$	
	6 Cal 6-19-57		\$	
	O'head		\$	
			\$	

Top by Gifford
6 Cal 6-19-57

W. W. WILSON

Str. Rd. ✓

Pl:

Ave. No. 46


Kensington

Name of Owner

Donald Creal

Labor and Mat'l. Report

June 19 19 57

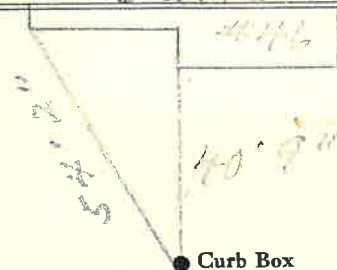

16" Main

Elev. of Main at tap

4'

Gate at ●

● Gate at

● Curb Box