


LABOR AND MATERIALS

1	Copper	Lead	Connection	3/4"		\$ 2.76
1	Curb	Cock Valve	T. S. & V.	3/4 in.		\$ 3.49
1	Service box	Short 3/4 X 4 1/2	Old returned	Long 4 1/2 X 5 1/2		\$ 4.74
32	Ft.	3/4 in.	Copper	Pipe at	38	\$ 12.16
			C.I.			
	Nipples	in.	at			\$
	Bushings	to	in.	at		\$
	Inc'g	Coupl'gs	to	in.	at	\$
	Union	in.	at			\$
	Meter	in.	at			\$
	Lead Joints	at				\$
	Compound Joints	at				\$
	Hrs. Water Maint. Man-1	at				\$
3	Hrs. Water Maint. Man-2	at	1.24			\$ 3.72
6	Hrs. Labor	at	1.13			\$ 6.78
	Hrs. Labor	at				\$
	Hrs. Compressor	at				\$
	Compensation Ins.	at \$4.06	per C			\$.46
	Trucking					\$ 1.00
	Pav't Patch					\$
	Tap by J. S. S. A. D. 4-20-53					\$
	O'head					\$
						\$ 35.11
						2.94
						32.17

21-53 Block-1 - Lot. 4-5
 Dixon Rd St.
 Kensington Rd Pl. No. 51

Name of Owner Gagliano

Labor and Mat'l. Report April 20 1953

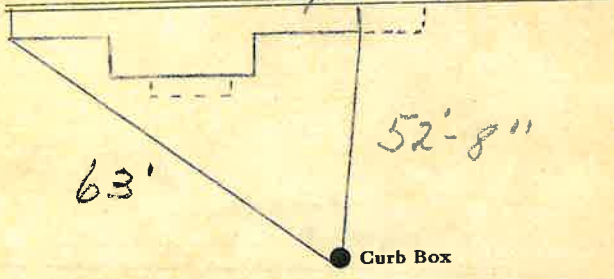

16" Main Elev. of Main at tap 5'

Gate at ● ● Gate at

● Curb Box