


**Labor and Materials**

1	Copper Connection	3/4"	\$ 2.60
1	Curb } Cock Valve	3/4" in.	\$ 2.30
		T.S. & V.	
1	Service Box } Short 3 1/2 x 1 1/2		\$ 1.40
	Old returned } Long 4 x 2 1/2		
		Buff. or Rdway	
24	Ft. } Copper		\$ 6.36
		Galv. Iron Pipe at	
		Cast Iron	
	Nipples	in. at	\$
	Bushings	to in. at	\$
	Red'g } Couplings	to in. at	\$
	Inc'g }		
	Union	in. at	\$
	Meter	in. at	\$
	Lbs. Br. Stone	at	\$
	Lbs. Sand	at	\$
	Bags Cement	at	\$
	Paving Brick } Mack		\$
		Red	
		Asphalt	
	Lead Joints	at	\$
	Leadite Joints	at	\$
1	Hrs. Foreman	at	\$ 6.3
2	Hrs. Common Labor	at	\$ 1.00
	Hrs. Common Labor	at	\$
	Hrs. Mason	at	\$
	Hrs. Mason's Helper	at	\$
	Hrs. Compressor	at	\$
	Compensation Ins.		\$ .64
	Trucking		\$ 1.00
	Builders' Use of Water		\$
Total			\$ 15.33

Labor and Material Report

1929

Dixon Rd. 7/3  
Kilmington Road, Waldron

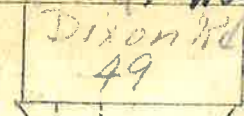

Curb Box

11 1/2" Main

Elev of Main at tap

4'

Gate at ●

● Gate at

Curb Box

was Clements.