

LABOR AND MATERIALS

1	Copper Lead	Connection	3/4"	\$	2.41
1	Curb	Cock Valve T.S. & V.	3/4 in.	\$	3.41
1	Service box Old returned	Short 3 1/2 x 4 1/2 Long 4 1/2 x 5 1/2 Buff or Rdway		\$	4.18
10	Ft.	Copper G.I. Pipe at	3/4 in.	\$	4.00
		Nipples	in. at	\$	
		Bushings	to in. at	\$	
		Red'g Inc'g	Coupl'gs. to in. at	\$	
		Union	in. at	\$	
		Meter	in. at	\$	
		Lead Joints at		\$	
		Compound Joints at		\$	
		Maintenance Foreman		\$	
		Hrs. Water Maint. Man-1 at		\$	
12 1/2		Hrs. Water Maint. Man-2 at	1.24	\$	15.50
		Hrs. Garage Foreman at		\$	
24		Hrs. Labor at	1.13	\$	27.12
		Hrs. Compressor at		\$	
		Compensation Ins. at \$	3.86 per C	\$	1.65
		Trucking		\$	1.50
		Pav't Patch		\$	9.00
		Tap by Giggard	10-5-54	\$	
		O'head		\$	
				\$	68.77


59.77

85-54

St. Kensington Rd. Pl. Ave. No. 4

Name of Owner Henry

Labor and Mat'l. Report Oct. 5 1954

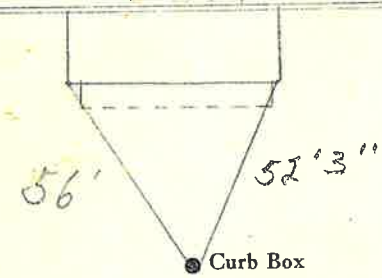

16" Main Elev. of Main at tap 4'

Gate at ● Gate at ●

● Curb Box