

#48

Labor and Materials


1	Copper	Connection	3	\$ 1.48
1	Lead		1	
1	Curb	Cock Valve T.S.W.	3	\$ 1.79
1	Service Box	Short 3 1/2 x 4 1/2	4	\$ 1.30
	Old returned	Long 4 1/2 x 5 1/2		
		Buff. or Hdw.		
9	Ft.	Copper Pipe at	3	\$ 1.62
		Cast Iron	4	
	Nipples	in. at		\$
	Bushings	to in. at		\$
	Red'g Inc'g	Couplings to in. at		\$
	Union	in. at		\$
	Meter	in. at		\$
	Lbs. Br. Stone	at		\$
	Lbs. Sand	at		\$
	Bags Cement	at		\$
	Paving Brick	Mack Red Asphalt at		\$
	Lead Joints	at		\$
	Leadite Joints	at		\$
6	Hrs.	Foreman at	3.75	\$
11	Hrs.	Common Labor at	4.95	\$
	Hrs.	Common Labor at		\$
	Hrs.	Mason at		\$
	Hrs.	Masons Helper at		\$
	Hrs.	Compressor at		\$
	Compensation Ins		1.77	\$
	Trucking		1	\$
	Builders Use of Water	Patch	5	\$

Total \$ 21.16

32-48

Labor and Material Report May 17 1932

6 Kensington Court Road

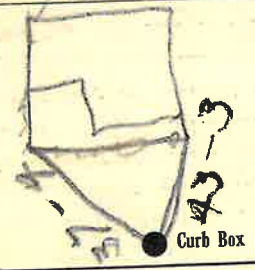

14 Main Elev. of Main at tap 4

Gate at ● Gate at ●

● Curb Box

old tap shut off at main

OK JTW