

Labor and Materials

Copper } Connection.....	3	\$ 1.25
Lead }		
Curb { Cock Valve & S.V. }	3/4	\$ 1.70
Service Box { Short 3 1/2 x 4 1/2 }		\$ 1.37
Old returned { Long 4 1/2 x 5 1/2 }		
15 Ft. 3/4 in. { Copper Galv. Iron Cast Iron } Pipe at 13 1/2		\$ 2.01
Nipples		\$
Bushings		\$
Red'g Inc'g } Couplings.....		\$
Union.....		\$
Meter.....		\$
Lbs. Br. Stone at		\$
Lbs. Sand at		\$
Bags Cement at		\$
Paving Brick { Mack Red Asphalt } at		\$
Lead Joints at		\$
Leadite Joints at		\$
4 1/2 Hrs. Foreman at	6 2/2	\$ 2.82
1 1/2 Hrs. Common Labor at	45	\$ 8.10
Hrs. Common Labor at		\$
Hrs. Mason at		\$
Hrs. Masons Helper at		\$
Hrs. Compressor at		\$
Compensation Ins		\$.41
Trucking		\$ 1.-
Builders Use of Water	Patch	\$ 5.-

Total \$ 23.66


1935-15

Labor and Material Report

Op. 27 1935

12 Kensington Road

SEWER-
OUTSIDE
CLEAN OUT
INSTALLED MAY 2004
LOCATED 2'
FROM CURB BOX.

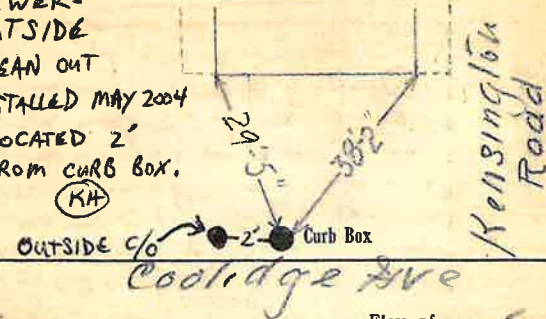

6 Main

Elev of Main at tap 5

Gate at ●

● Gate at

● Curb Box

old tap disconnected
The tap is made from
Coolidge Ave main

[Handwritten signature]