

Labor and Materials

1	Copper	Connection	3/4"	\$	
1	Curb	Cock	3/4	in	\$
		Wells			
		I. S. & V.			
1	Service Box	Short	3 1/2 x 4 1/2		\$
	Old returned	Long	4 1/2 x 5 1/2		\$
		Buff. or Rdway			\$
?	Ft.	3/4	in.		\$
		Copper		Pipe at	\$
		Galv Iron			\$
		Cast Iron			\$
	Nipples	in. at			\$
	Bushings	to	in. at		\$
	Red'g	Conplings	to	in. at	\$
	Inc'g				\$
	Union	in. at			\$
	Meter	in. at			\$
	Lead Joints	at			\$
	Leadite Joints	at			\$
	Hrs. Foreman	at			\$
	Hrs. Chauffeur	at			\$
	Hrs. Tapper	at			\$
	Hrs. Labor	at			\$
	Hrs. Labor	at			\$
	Hrs. Compressor	at			\$
	Compensation Ins.				\$
	Trucking				\$
	Builders Use of Water				\$
	TOP 10 1928				\$
					\$
					\$
28-165

PA.
St.
Pt.

Kensington


Ave. No. 28

Name of Owner

TAX ID # 302.15-5-2

Labor and Mat'l. Report

1928

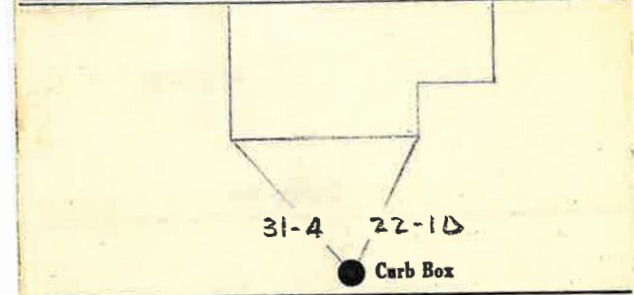

Main Elev. of Main at tap

Gate at ● ● Gate at

● Curb Box

Measured in
Feb. 17, 1938.