

LABOR AND MATERIALS


?	Copper	}	Connection	\$		
	Lead					
?	Curb	}	Cock	in.	\$	
			Valve			
			T. S. & V.			
1	Service box	}	Short 3½ x 4½			
	Old returned		Long 4½ x 5½			
			Buff or Rdway		\$	
	Ft.	}	}	in.	\$	
		Copper	Pipe at			
		G. I. ?				
		C. I.				
	Nipples		in. at		\$	
	Bushings		to in. at		\$	
	Red'g	}	Coupl'gs	to in. at	\$	
	Inc'g					
	Union		in. at		\$	
	Meter		in. at		\$	
	Lead Joints at				\$	
	Compound Joints at				\$	
	Maintenance Foreman				\$	
	Hrs. Water Maint. Man-1 at				\$	
	Hrs. Water Maint. Man-2 at				\$	
	Hrs. Garage Foreman at				\$	
	Hrs. Labor at				\$	
	Hrs. Compressor at				\$	
	Compensation Ins. at \$		per C		\$	
	Trucking				\$	
	Pav't Patch				\$	
					\$	
					\$	
	O'head				\$	
					\$	

-St-
-Pl-
Ave. No. 13

Name of Owner

Measured in

Labor and Mat'l. Report Oct. 1957

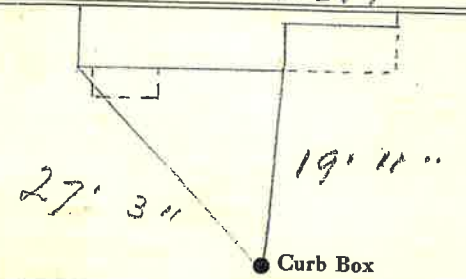

Main Elev. of Main at tap

Gate at ● ● Gate at

● Curb Box