


Labor and Materials

Copper } Connection $\frac{3}{4}$	\$ 3.20
Lead }	
Curb { Cock Valve } in $\frac{3}{4}$	\$ 1.00
{ T. S. & V. }	
Service Box } Short 3" x 4"	\$ 1.30
Old returned }	
8 Ft. in. } Copper } Pipe at $\frac{3}{4}$	\$ 1.26
} Galv. Iron }	
} Cast Iron }	
Nipples.....in. at.....	\$
Bushings.....to.....in. at.....	\$
Red'g } Couplings.....to.....in. at.....	\$
Inc'g }	
Union.....in. at.....	\$
Meter.....in. at.....	\$
Lbs. Br. Stone at.....	\$
Lbs. Sand at.....	\$
Bags Cement at.....	\$
Paving Brick { Mack } at.....	\$
{ Red }	
{ Asphalt }	
Lead Joints at.....	\$
Leadite Joints at.....	\$
5 Hrs. Foreman at.....	\$ 1.50
Hrs. Common Labor at.....	\$
4 Hrs. Common Labor at.....	\$ 1.63
Hrs. Mason at.....	\$
Hrs. Mason's Helper at.....	\$
Hrs. Compressor at.....	\$
Compensation Ins.....	\$.09
Trucking.....	\$ 1.00
Builders' Use of Water.....	\$
Total \$ 11.48	

26-128 21 avg 26
 Labor and Material Report 1926

17 Rem. worthy

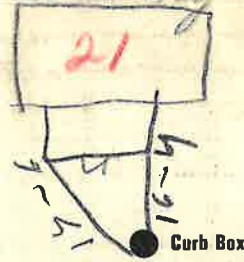

21 Main Elev. of Main at tap 4 1/2
 Gate at ● Gate at ●

● Curb Box

Old connection
 to be dug up