


Labor and Materials

Copper } Connection.....	?	2.60
Lead } .....	?	
Curb { Cock Valve } .....	?	2.27
{ T.S. } .....		
Service Box } Short 3 1/2 x 4 1/2 } .....	?	1.59
Old returned } Long 4 1/2 x 5 1/2 } .....		
{ Buff. or Repair } .....		
10 Ft. .... in. { Copper } Pipe at 3/4 .....	?	4.50
{ Galv. Iron } .....		
{ Cast Iron } .....		
Nipples ..... in. at .....		
Bushings ..... to ..... in. at .....		
Red'g } Couplings..... to ..... in. at .....		
Inc'g } .....		
Union..... in. at .....		
Meter..... in. at .....		
Lbs. Br. Stone at .....		
Lbs. Sand at .....		
Bags Cement at .....		
Paving Brick { Mack } at .....		
{ Red } .....		
{ Asphalt } .....		
Lead Joints at .....		
Leadite Joints at .....		
3 Hrs. Foreman at .....		1.98
10 Hrs. Common Labor at .....		4.50
Hrs. Common Labor at .....		
Hrs. Mason at .....		
Hrs. Masons Helper at .....		
Hrs. Compressor at .....		
Compensation Ins .....		20
Trucking .....		1.00
Builders Use of Water <i>Patrol</i> .....		5.00
Total		23.54

5 32-27 23 901 25 1932

Labor and Material Report

19 Kenworthy Ave

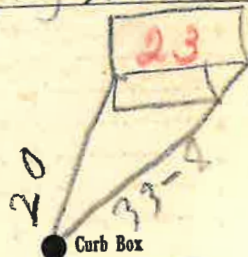

4 Main

Elev. of Main at tap 5

Gate at ●

● Gate at

TAX ID # 302.12-21-12

● Curb Box

old Tap shut off

OK 9/10