

Labor and Materials

Copper } Connection.....	$\frac{3}{4}$	\$ 2.70
Lead } {		
Curb } Cock		
Valve	$\frac{3}{4}$ in.	\$ 2.39
T. S. & V. }		
Service Box } Short $3\frac{1}{2} \times 4\frac{1}{2}$		
Old returned } Long $4\frac{1}{2} \times 6\frac{1}{2}$		\$ 1.45
Buff. or Rdway }		
31 Ft. in. } Copper	$\frac{3}{4}$	\$ 8.37
Galv. Iron } Pipe at		
Cast Iron }		
Nipples..... in. at.....		\$
Bushings..... to..... in. at.....		\$
Red'g } Couplings..... to..... in. at.....		\$
Inc'g }		
Union..... in. at.....		\$
Meter..... in. at.....		\$
Lbs. Br. Stone at.....		\$
Lbs. Sand at.....		\$
Bags Cement at.....		\$
Paving Brick } Mack		
Red		
Asphalt } at.....		\$
Lead Joints at.....		\$
Leadite Joints at.....		\$
4 Hrs. Foreman at.....		\$ 2.50
18 Hrs. Common Labor at.....		\$ 8.10
Hrs. Common Labor at.....		\$
Hrs. Mason at.....		\$
Hrs. Mason's Helper at.....		\$
Hrs. Compressor at.....		\$
Compensation Ins.....		\$ 33
Trucking.....		\$ 1.00
Builders' Use of Water Patch.....		\$ 5.00
Total		\$ 31.84


30-81

29

Labor and Material Report

July 17 1930

22 Hermonville ave.

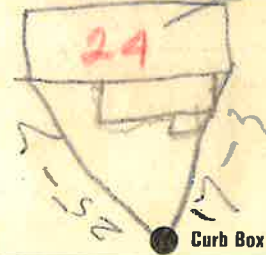

4 Main

Elev of Main at tap 52

Gate at ●

● Gate at

● Curb Box

old tap disconnected