


Labor and Materials

1	Copper	Connection	2	\$ 2.60
1	Lead		1	
1	Curb	Cock Valve	3/4	\$ 2.27
		Short 3 1/2 x 4 1/2		
	Service Box	Long 4 1/2 x 5 1/2		\$ 1.38
	Old returned	Buff. on Power		
11	Ft.	Copper Galv. Iron Cast Iron	3/4 in.	Pipe at \$ 1.98
	Nipples		in. at	\$
	Bushings		to in. at	\$
	Red'g Inc'g	Couplings	to in. at	\$
	Union		in. at	\$
	Meter		in. at	\$
	Lbs. Br. Stone		at	\$
	Lbs. Sand		at	\$
	Bags Cement		at	\$
	Paving Brick	Mack Red Asphalt	at	\$
	Lead Joints		at	\$
	Leadite Joints		at	\$
2	Hrs. Foreman		at	\$ 1.25
10	Hrs. Common Labor		at	\$ 4.50
	Hrs. Common Labor		at	\$
	Hrs. Mason		at	\$
	Hrs. Masons Helper		at	\$
	Hrs. Compressor		at	\$
	Compensation Ins			\$.18
	Trucking			\$ 1.00
	Builders Use of Water	Patch		\$ 5.00
Total \$				20.16

5 82-26 25 A-13 Labor and Material Report Cipi 25 1932

21-23 Kenworthy Ave

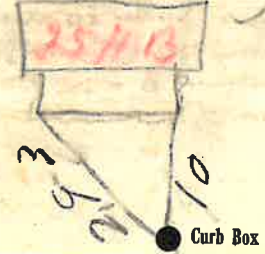

4 Main Elev. of Main at tap 5
 Gate at ● Gate at ●

● Curb Box

old Tap shut off

OK GWT