


LABOR AND MATERIALS

_____ Copper } Connection _____ \$ _____
 _____ Lead }
 _____ Curb } Cock } _____ in. _____ \$ _____
 _____ Valve }
 _____ T.S. & V. }
 _____ Service box { Short 3-1/2 x 4-1/2 } _____ \$ _____
 _____ Old returned { Long 4-1/2 x 5-1/2 }
 _____ Ft. _____ in. { Copper } Pipe at _____ \$ _____
 _____ { G.I. }
 _____ { C.I. }
 _____ Nipples _____ in. at _____ \$ _____
 _____ Bushings _____ to _____ in. at _____ \$ _____
 _____ Red'g _____
 _____ Inc'g _____
 _____ Union _____ in. at _____ \$ _____
 _____ Meter _____ in. at _____ \$ _____
 _____ \$ _____
 _____ Compound Joints at _____ \$ _____
 _____ Maintenance Foreman _____ \$ _____
 _____ Hrs. Water Maint. Man - 1 at _____ \$ _____
 _____ Hrs. Water Maint. Man - 2 at _____ \$ _____
 _____ Hrs. Garage Foreman _____ at _____ \$ _____
 _____ Hrs. Labor _____ at _____ \$ _____
 _____ Hrs. Compressor at _____ \$ _____
 _____ \$ _____
 _____ Trucking _____ \$ _____
 _____ Pav't Patch _____ \$ _____
 _____ \$ _____
 _____ \$ _____
St. _____
 Pl. _____
 Ave. No. 4
KIDDER
 Name of Owner _____

Labor and Mat'l. Report ~~40~~ 2015

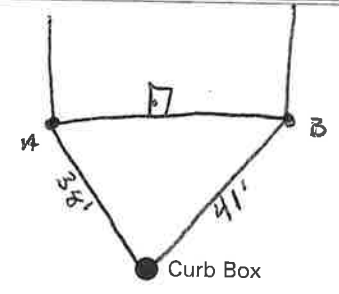

15' to Main Elev. of Main at tap _____
 Gate at ● ● Gate at _____
 ● Curb Box