


LABOR AND MATERIALS


Copper } Connection _____ \$ _____
 Lead }
 Curb } Cock } _____ in. _____ \$ _____
 Valve }
 T.S. & V. }
 Service box { Short 3-1/2 x 4-1/2 } _____ \$ _____
 Old returned { Long 4-1/2 x 5-1/2 }
 Ft. _____ in. { Copper } Pipe at _____ \$ _____
 { G.I. }
 { C.I. }
 Nipples _____ in. at _____ \$ _____
 Bushings _____ to _____ in. at _____ \$ _____
 Red'g _____
 Inc'g _____
 Union _____ in. at _____ \$ _____
 Meter _____ in. at _____ \$ _____
 _____ \$ _____
 Compound Joints at _____ \$ _____
 Maintenance Foreman _____ \$ _____
 Hrs. Water Maint. Man - 1 at _____ \$ _____
 Hrs. Water Maint. Man - 2 at _____ \$ _____
 Hrs. Garage Foreman _____ at _____ \$ _____
 Hrs. Labor _____ at _____ \$ _____
 Hrs. Compressor at _____ \$ _____
 _____ \$ _____
 Trucking _____ \$ _____
 Pav't Patch _____ \$ _____
 _____ \$ _____
 _____ \$ _____
 _____ \$ _____
 _____ \$ _____

St. _____
 Pl. _____
 Ave. No. 6
KIDDER
 Name of Owner _____

Labor and Mat'l. Report 4-2015

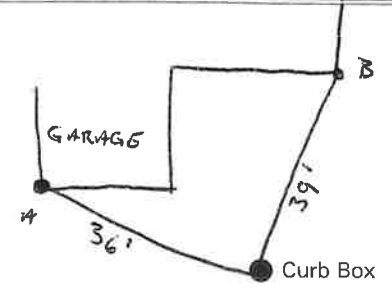

16' To Main _____ Elev. of Main at tap _____
 Gate at ● _____ Gate at ● _____

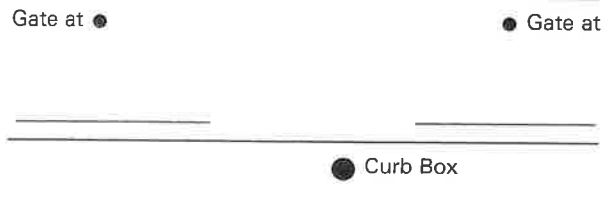

LABOR AND MATERIALS

Copper } Connection		\$
Lead } {		
Curb } Cock	} in.	\$
Valve		
T. S. & V.		
Service box	{ Short 3½ x 4½ }	\$
Old returned	{ Long 4½ x 5½ }	
Ft. 3/4 in.	{ Copper } Pipe at	\$
	{ G. I. }	
	{ C. I. }	
Nipples	in. at	\$
Bushings	to in. at	\$
Red'g } Coupl'gs	to in. at	\$
Inc'g }		
Union	in. at	\$
Meter	in. at	\$
		\$
Compound Joints	at	\$
Maintenance Foreman		\$
Hrs. Water Maint. Man—1	at	\$
Hrs. Water Maint. Man—2	at	\$
Hrs. Garage Foreman	at	\$
Hrs. Labor	at	\$
Hrs. Compressor	at	\$
		\$
Trucking		\$
Pav't Patch		\$
		\$
		\$
		\$
		\$


LANE
ST.
PT.
Ave. No. 6

KIDDER

Name of Owner

Labor and Mat'l. Report

1992

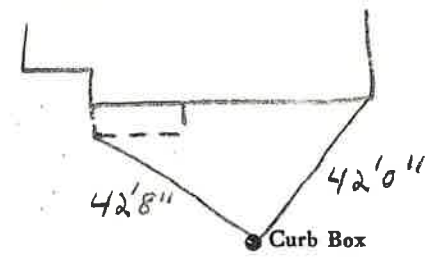

Main

Elev. of
Main at tap

Gate at ●

● Gate at

● Curb Box